

**FLOOR PLAN**

Approximate Scale: 3/32":1'-0"

THESE DRAWINGS  
ARE FOR  
FUNCTIONAL  
SPACE  
PROGRAMMING  
ONLY.

APPROXIMATE MATCH LINE

A  
1

B  
1

APPROXIMATE MATCH LINE



FLOOR PLAN

Approximate Scale: 3/32":1'-0"

STRUX

ENGINEERING LLC

PO BOX 324

31448 DIXIE CREEK RD

PRAIRIE CITY, OR 97869

ENGINEER@STRUXENGINEERING.COM

PROJECT LOCATION:  
WEAVER BLDG JOHN DAY, OR 97845  
OWNER REPRESENTATIVE:  
AARON LIEUALLEN

EAST BUILDINGS  
SECOND STORY

THESE DRAWINGS  
ARE FOR  
FUNCTIONAL  
SPACE  
PROGRAMMING  
ONLY.

DATE: 12/09/2017

DESIGN:


DRAWN: MCW


CHECK:


SHEET

2

OF 4 SHEETS

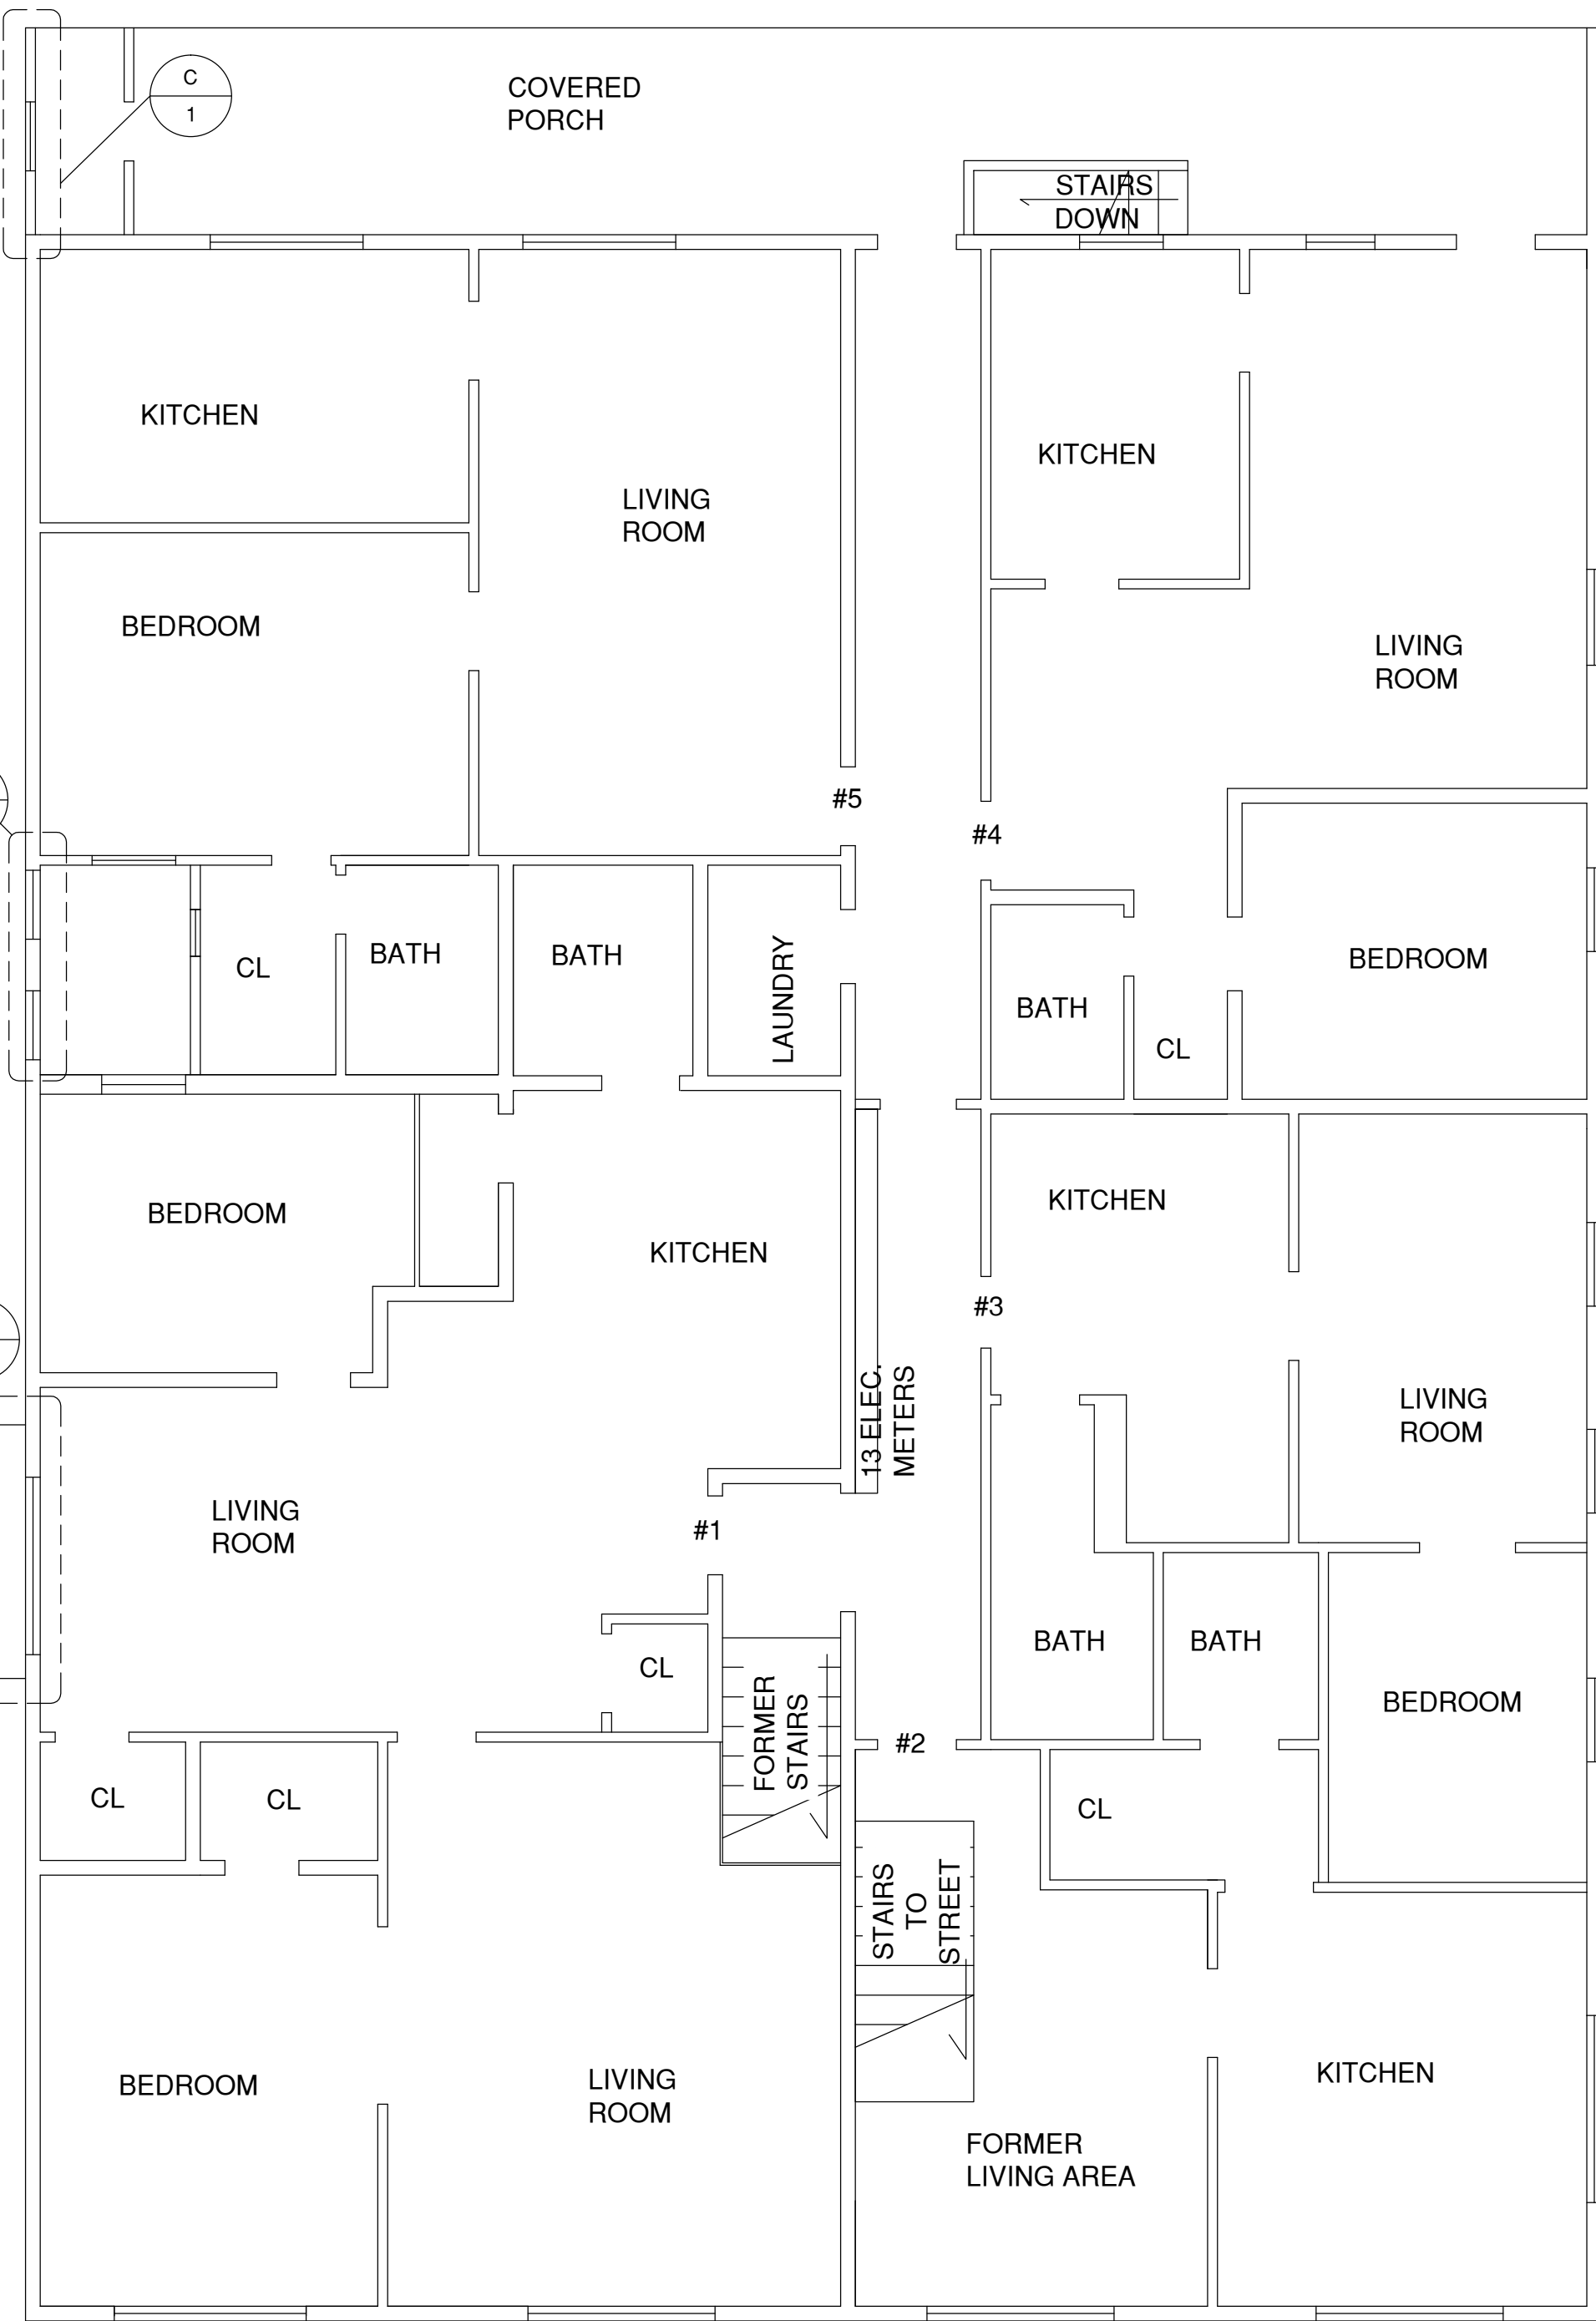

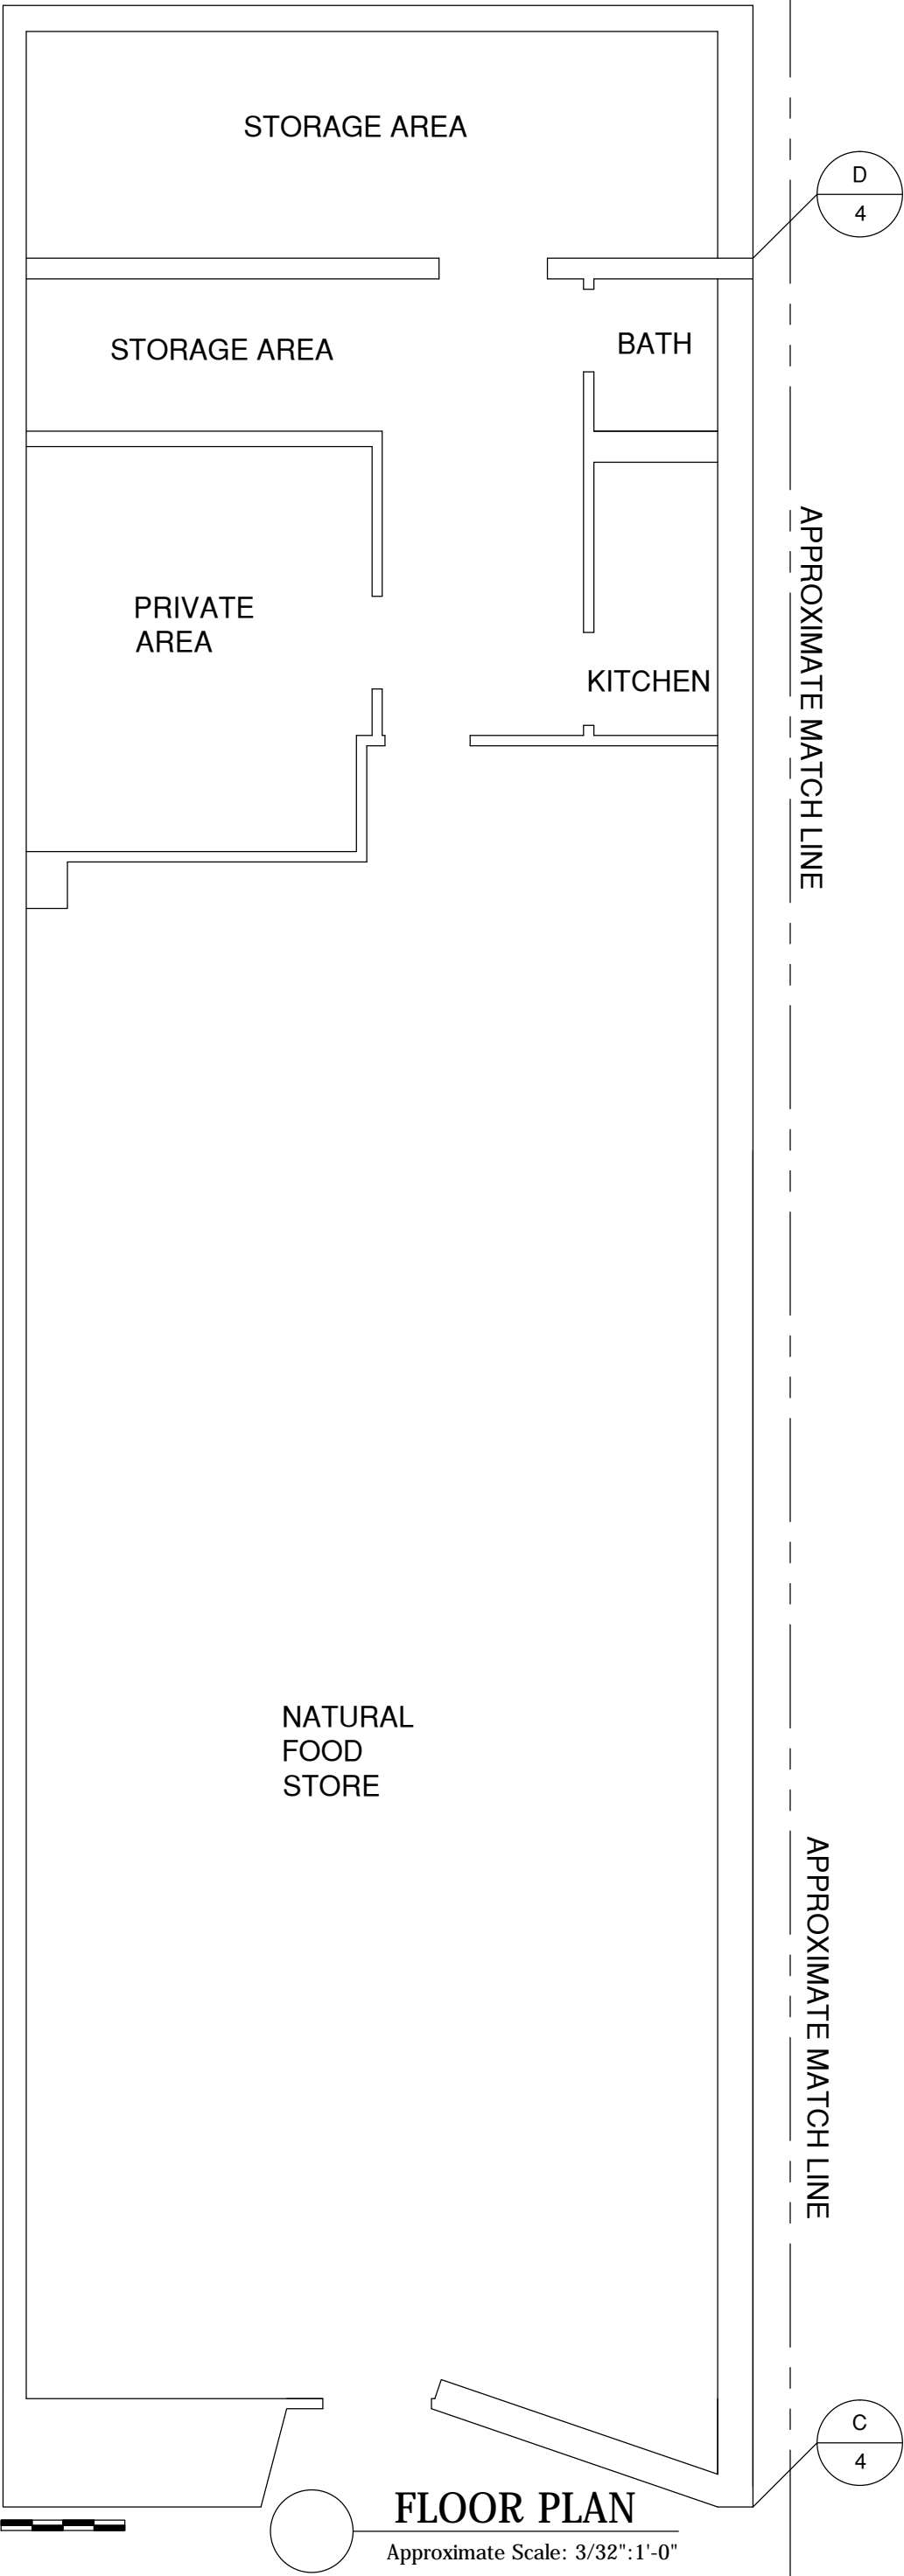


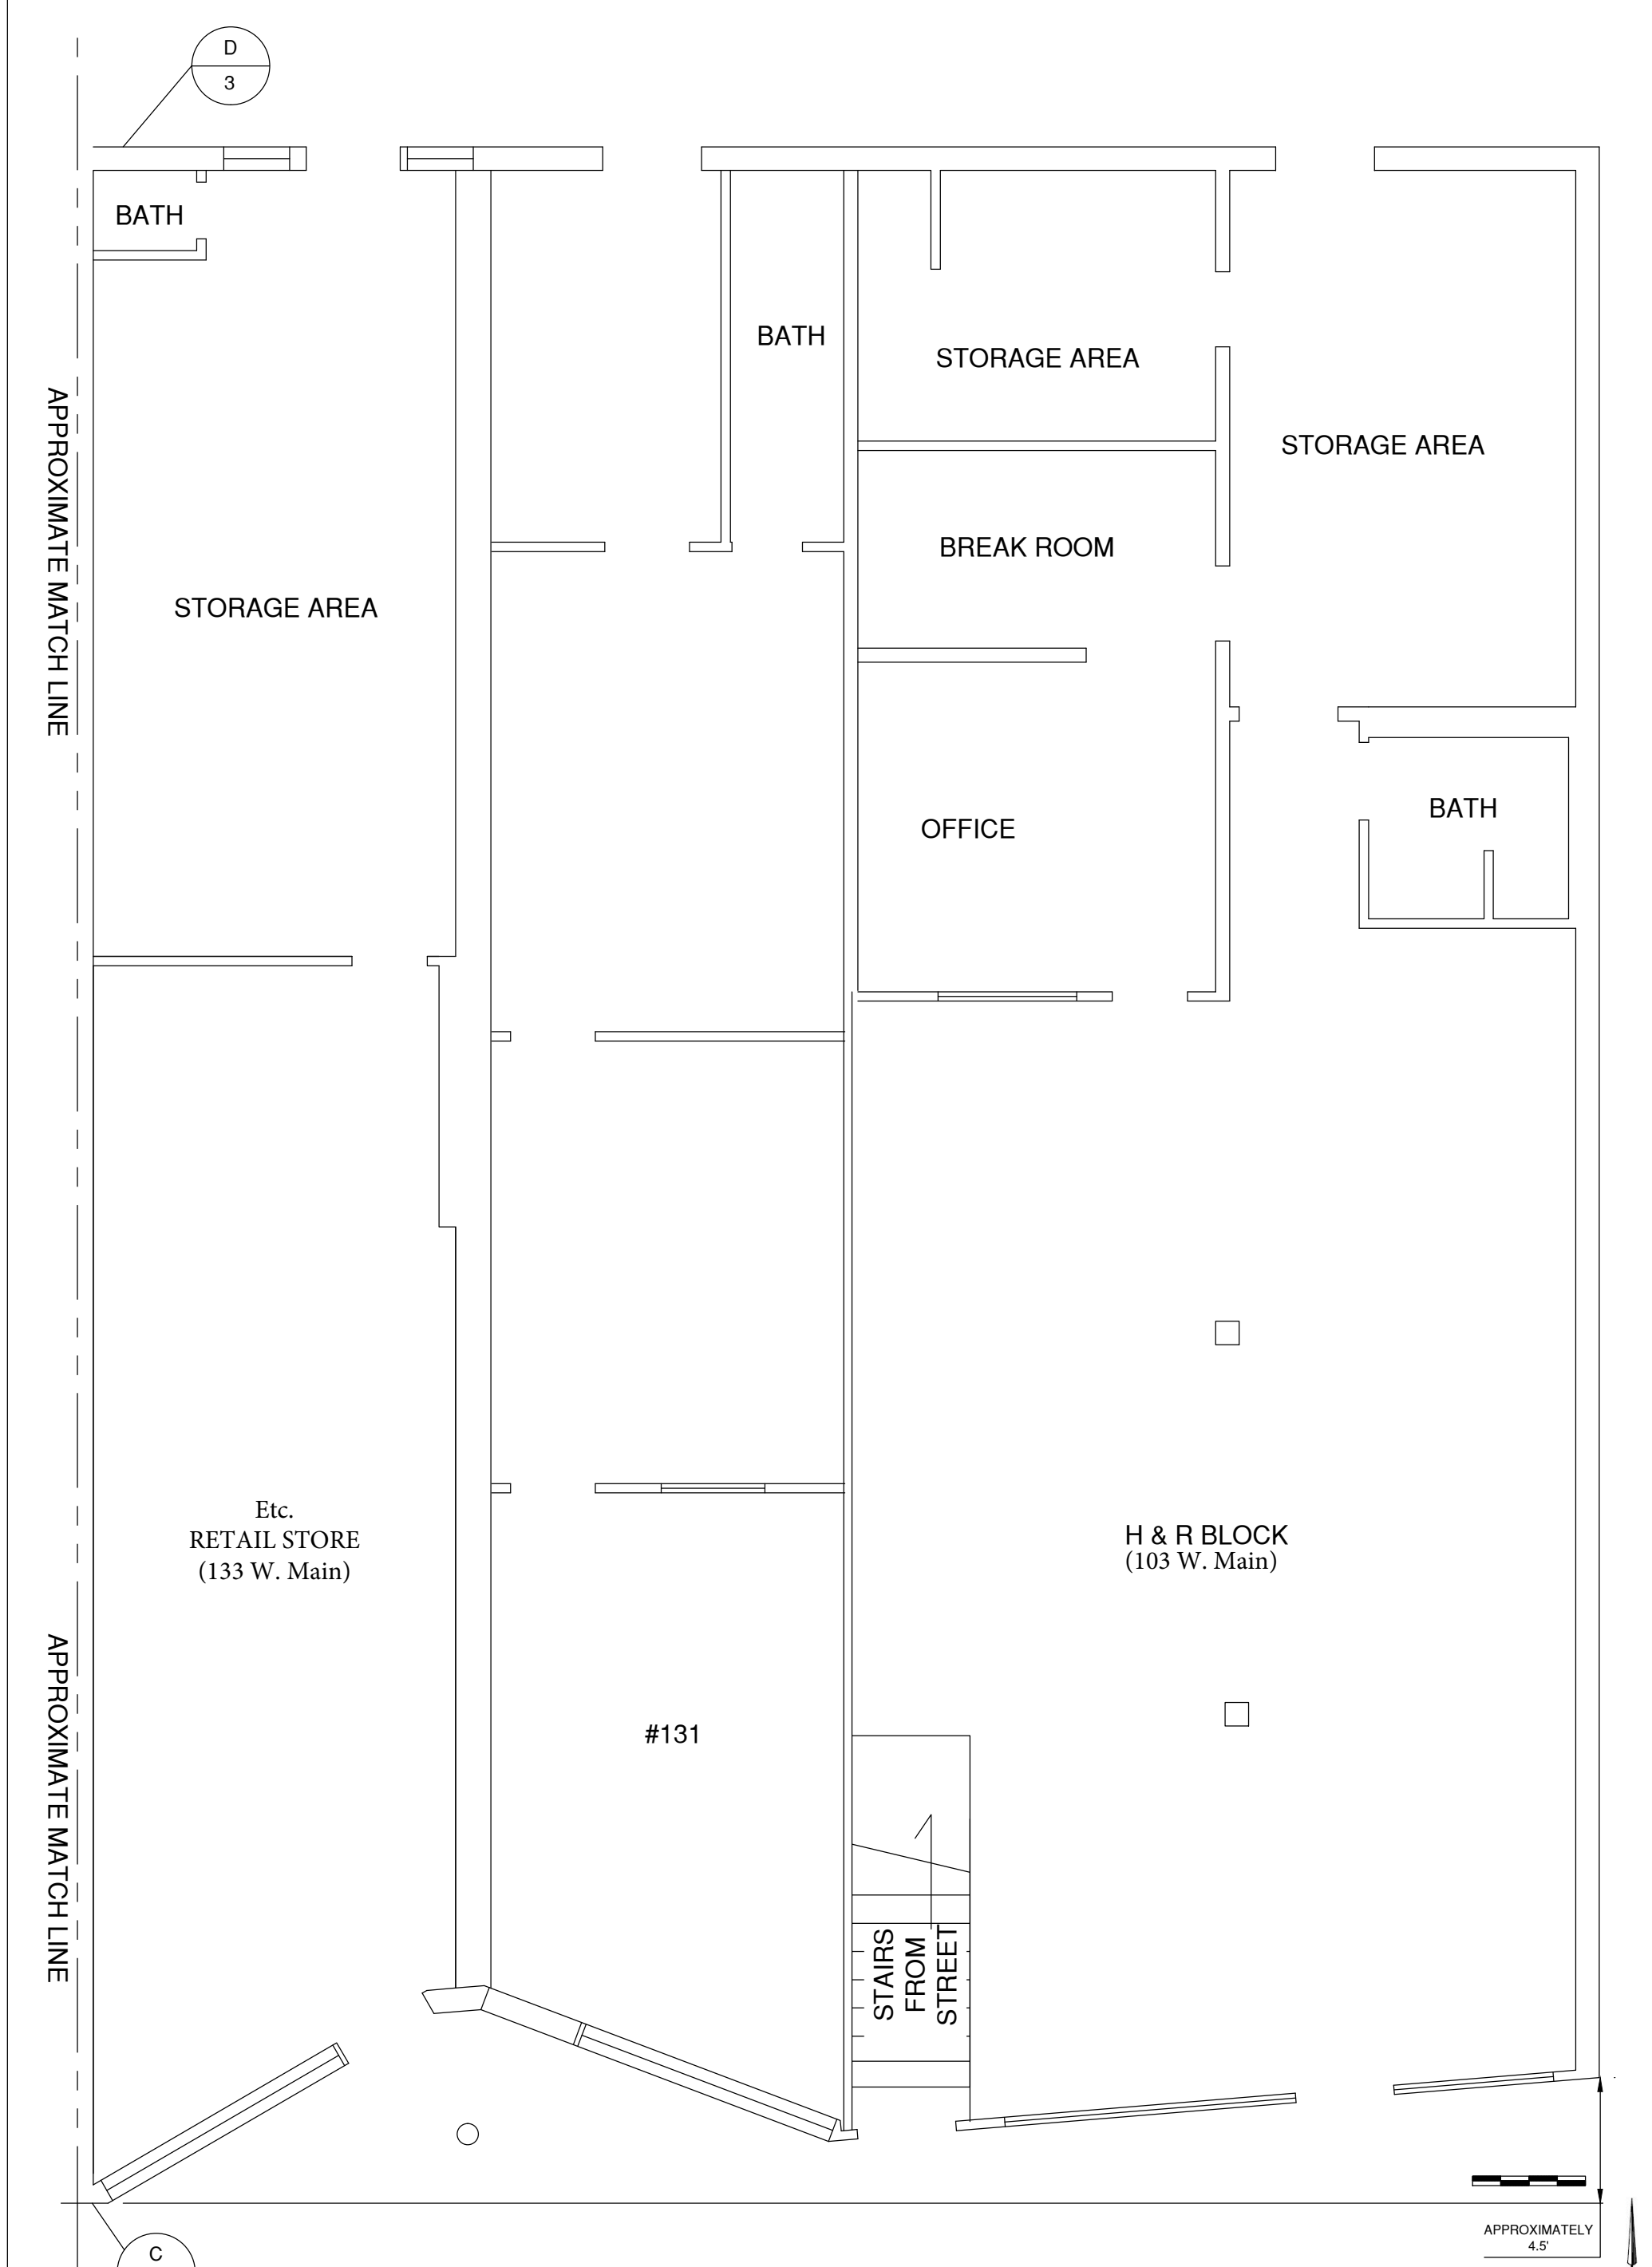

APPROXIMATE MATCH LINE

APPROXIMATE MATCH LINE

APPROXIMATELY  
4.5'

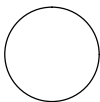

## FLOOR PLAN

Approximate Scale: 3/32":1'-0"